NMO-002-406.1A-AKDN-12 6

GENERAL NOTES

1. THE AS BUILT INFORMATION OF THE EXISTING VESSEL IS ASSUMED TO BE CORRECT. ON BOARD SURVEY OF THE ACTUAL SITUATION TO BE PERFORMED PRIOR TO DETAILED ENGINEERING.
2. ALL DIMENSIONS IN MM UNLESS OTHERWISE STATED.

MAIN DIMENSIONS (after up gradation)

LENGTH o.a.	165.30 M
LENGTH pp.	136.80 M
BREADTH mld.	21.35 M
BREADTH (Extreme)	31.25 M
DEPTH to main deck at side mld.	12.50 M
DESIGN DRAFT	7.50 M

REFERENCE DRAWINGS

ED.01.12	G.A. MAIN DECK AND TWEENDECK (S.O.S.)
ED.50.11	1,5 DERRICK DRILL FLOOR ARRANGEMENT (S.O.S.)
ED.01.14	G.A. ACCOMMODATION (S.O.S.)
ED.51.23	POOP DECK & RISER STORAGE DECK ARRANGEMENT (S.O.S.)
ED.25.11	FIRE FIGHTING & DECK WASH SYSTEMS PRINCIPLE DIAGRAM (S.O.S.)

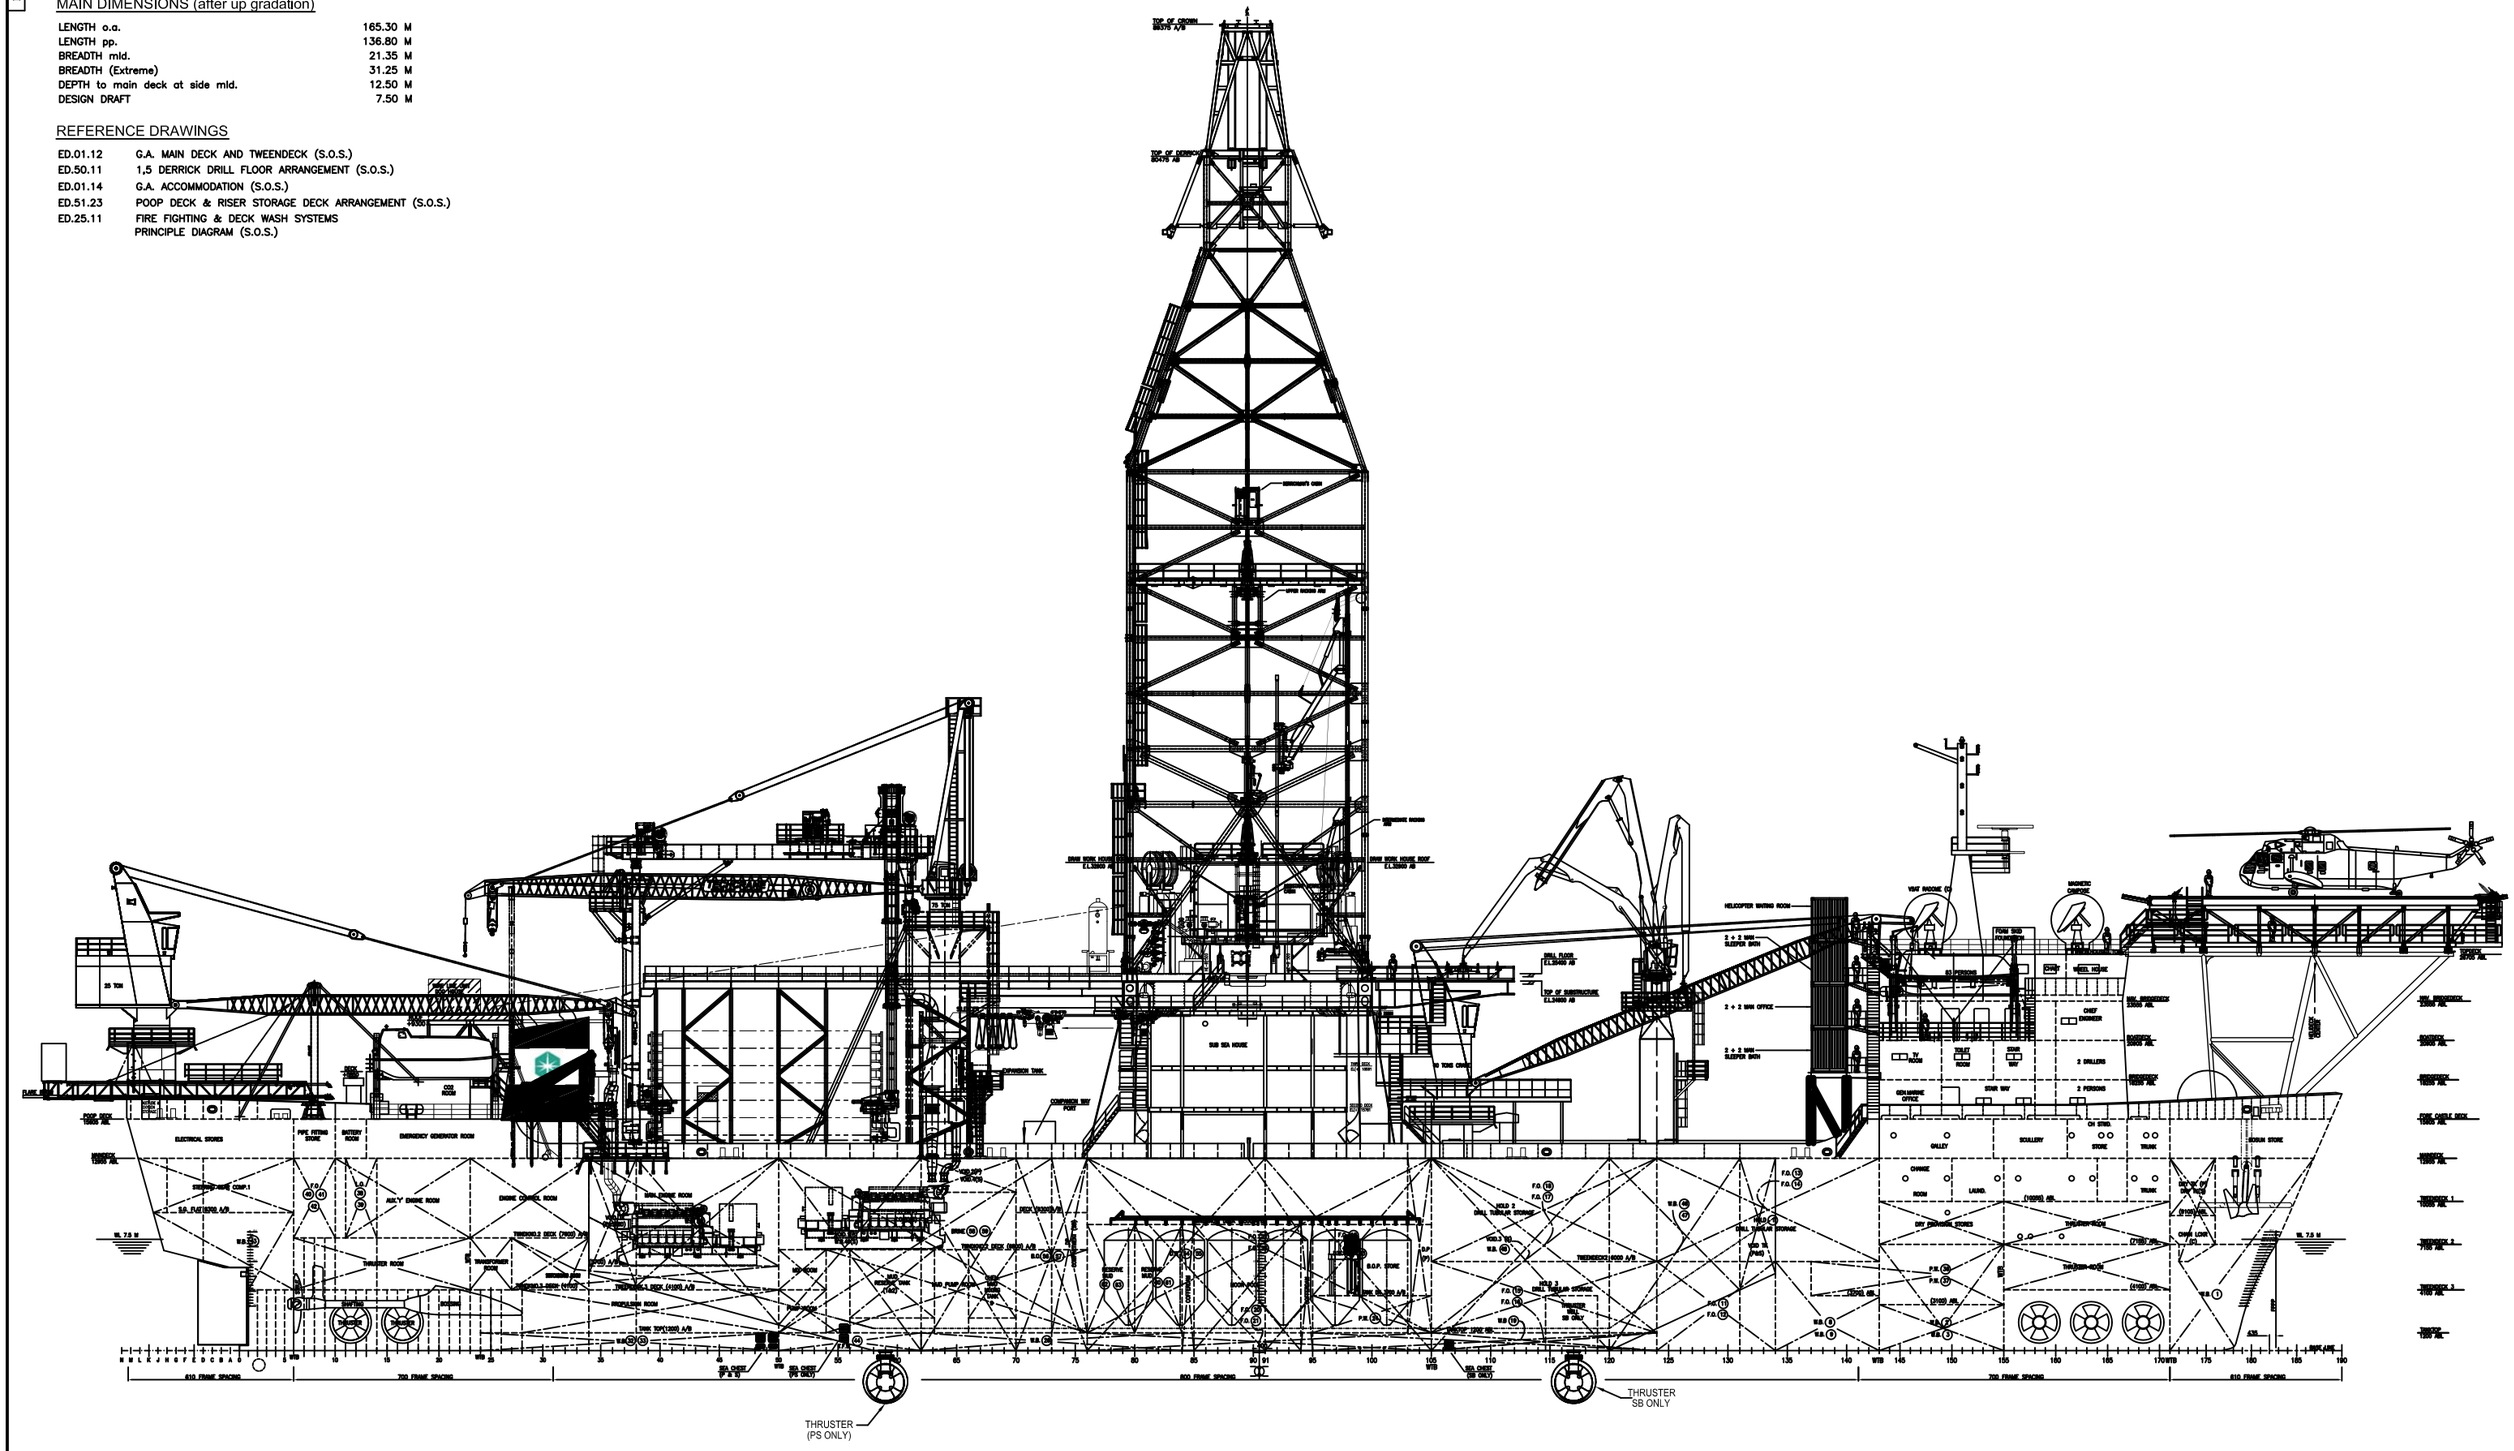

REV.	DATE	DESCRIPTION	BY	CHECKED	APPR.
6	29/01/14	AS BUILT _COMPANY LOGO IN THE FUNNEL CHANGED	REX		
5	07/10/10	AS BUILT _COMPANY NAME/LOGO CHANGED	MKA		
4	12/01/09	REVISED DRAWING	MKR	PCR	
3	30/07/07	BREADTH (EXTREME) UPDATED	SHA	MKA	
2	26/06/07	DRAWING UPDATED – UPGRADE 5,000 ft. (N.M.O.)	SHA	JM	
1	26/10/06	DRAWING UPDATED – UPGRADE 5,000 ft. (S.O.S.)	SHA	JM	
0	17/1/06	PRE – ENGINEERING DESIGN (Upgrade 3,500 ft.)	SHA	FRTS	

DESCRIPTION

GENERAL ARRANGEMENT
PROFILE VIEW

DRAWN BY: SHAFIE	DATE: 26/10/06
CHECKED: GSA	
APPROVED BY	
SCALE: 1 : 150	
SHT: 1of1	

Jasper Offshore

PROJECT: JASPER OFFSHORE

PREPARED BY: ENGINEERING AND DESIGN

THIS DRAWING IS CONFIDENTIAL AND REMAINS THE PROPERTY OF JASPER OFFSHORE. IT IS LOANED SUBJECT TO AN AGREEMENT THAT IT SHALL NOT BE COPIED, USED OR MADE AVAILABLE FOR ANY PURPOSE OTHER THAN THAT FOR WHICH IT IS EXPRESSLY LOANED BY JASPER OFFSHORE WITHOUT THE PRIOR WRITTEN PERMISSION. ALL RIGHTS RESERVED IN THE EVENT OF PUBLICATION.

DRAWING NUMBER: NMO-002-406.1A-AKDN-12 | REV: 6 | SIZE: A0