NMO-002-406.1A-AKDN-12 | 6

GENERAL NOTES

1. THE AS BUILT INFORMATION OF THE EXISTING VESSEL IS ASSUMED TO BE CORRECT. ON BOARD SURVEY OF THE ACTUAL SITUATION TO BE PERFORMED PRIOR TO DETAILED ENGINEERING.
2. ALL DIMENSIONS IN MM UNLESS OTHERWISE STATED.

MAIN DIMENSIONS (after up gradation)

LENGTH o.a.	165.30 M
LENGTH pp.	136.80 M
BREADTH mld.	21.35 M
BREADTH (Extreme)	31.25 M
DEPTH to main deck at side mld.	12.50 M
DESIGN DRAFT	7.50 M

REFERENCE DRAWINGS

ED.01.12	G.A. MAIN DECK AND TWEENDECK (S.O.S.)
ED.50.11	1,5 DERRICK DRILL FLOOR ARRANGEMENT (S.O.S.)
ED.01.14	G.A. ACCOMMODATION (S.O.S.)
ED.51.23	POOP DECK & RISER STORAGE DECK ARRANGEMENT (S.O.S.)
ED.25.11	FIRE FIGHTING & DECK WASH SYSTEMS PRINCIPLE DIAGRAM (S.O.S.)

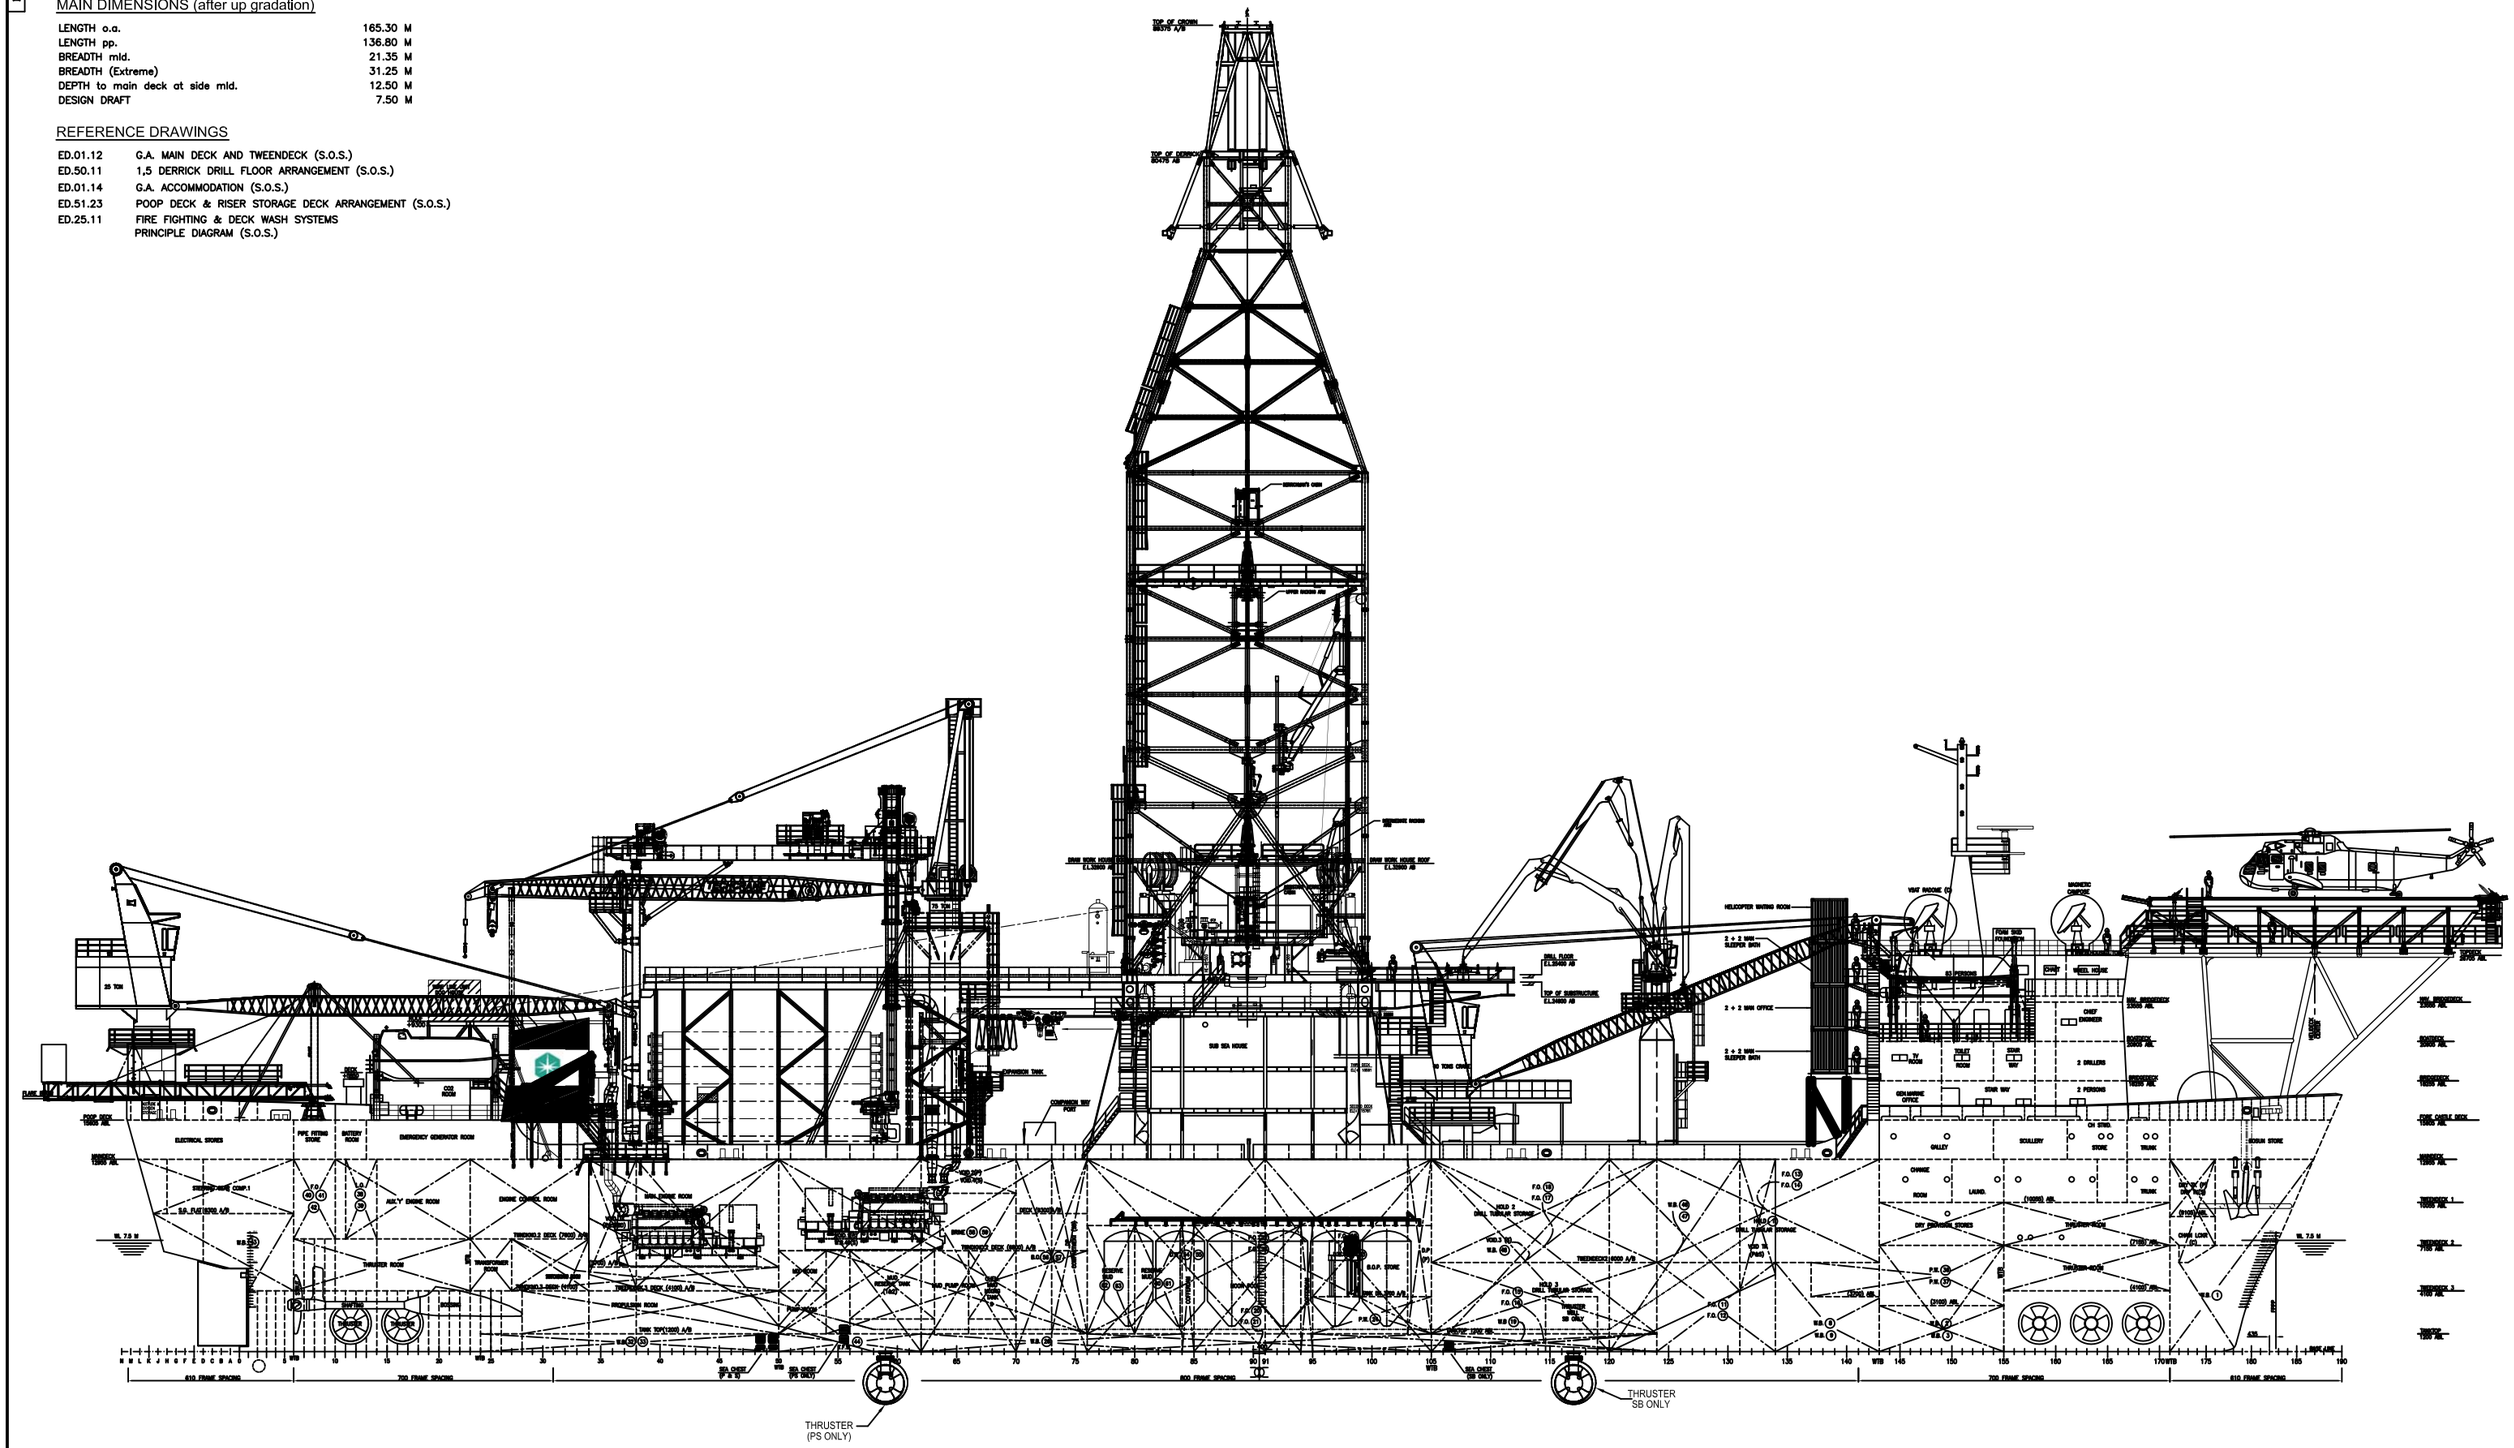

REV.	DATE	DESCRIPTION	BY	CHECKED	APPR.
6	28/01/14	AS BUILT _COMPANY LOGO IN THE FUNNEL CHANGED	REX		
5	07/16/10	AS BUILT _COMPANY NAME/LOGO CHANGED	MWA		
4	12/01/08	REVISED DRAWING	MWB	PEDR	
3	30/07/07	BREADTH (EXTREME) UPDATED	SHA	MWA	
2	26/06/07	DRAWING UPDATED – UPGRADE 5,000 ft. (N.M.O.)	SHA	JM	
1	26/10/06	DRAWING UPDATED – UPGRADE 5,000 ft. (S.O.S.)	SHA	JM	
0	17/1/06	PRE – ENGINEERING DESIGN (Upgrade 3,500 ft.)	SHA	FRTS	

DESCRIPTION

GENERAL ARRANGEMENT
PROFILE VIEW

DRAWN BY SHAFIE	DATE 26/10/06	
CHECKED GSA		
APPROVED BY		
SCALE 1 : 150		
SHT 1of1		

Jasper Offshore

PROJECT: JASPER OFFSHORE

PREPARED BY: ENGINEERING AND DESIGN

THIS DOCUMENT IS CONFIDENTIAL AND REMAINS THE PROPERTY OF COMPANY OR AMONG COMPANY. ALL RIGHTS RESERVED. IN WHOLE OR PART, COPYING OR REPRODUCTION OF THIS DOCUMENT IS STRICTLY NOT ALLOWED WITHOUT THE WRITTEN CONSENT OF THE OWNER.

DRAWING NUMBER: NMO-002-406.1A-AKDN-12 | REV 6 | SIZE A0